



1
A-D-1
DEMOLITION AND REMOVAL PLAN
SCALE: 1"=10'

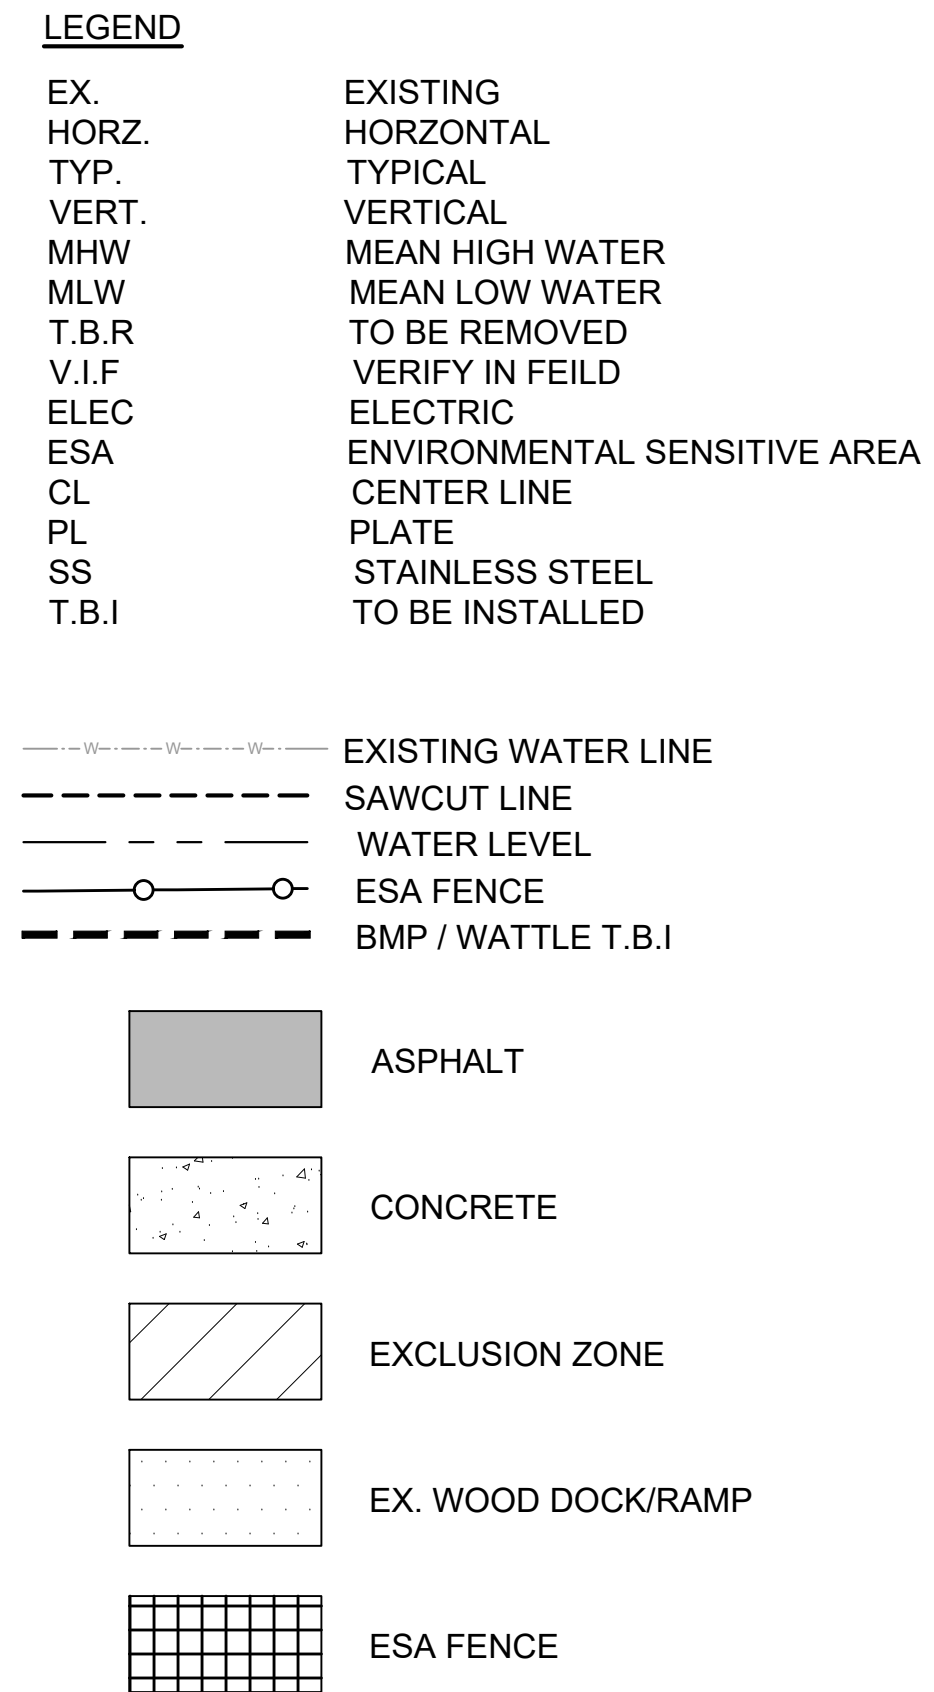


- NO. DEMOLITION NOTES**
- 1 REMOVE EXISTING WOOD DOCK/RAMPS ALONG WITH ALL SUPPORTS TO EXTENTS SHOWN ON ELEVATION A & B. DISPOSE OF EXISTING MATERIAL ACCORDING TO PROJECT SPECIFICATIONS. ⚠️
 - 2 REMOVE AND DISPOSE OF EXISTING WINCH AND SUPPORT SYSTEM. REFER TO DEMOLITION PHOTO 1/D-3 FOR MORE INFORMATION. ADHERE TO REMOVAL REQUIREMENTS IN PROJECT SPECIFICATIONS.
 - 3 REMOVE AND DISPOSE OF EXISTING RAILING ACCORDING TO PROJECT SPECIFICATIONS.
 - 4 REMOVE 67 FT OF EXISTING SECURITY CHAIN LINK FENCE IN ACCORDANCE WITH PROJECT SPECIFICATIONS. REPLACE WITH NEW FENCING AND TIE IN TO LOCATION SPECIFIED ON SHEET C-1. SITE MAY NOT BE LEFT ACCESSIBLE AT ANY TIME. MUST BE SECURE FROM PERSONS FROM THE WATER. CONTRACTOR TO SUBMIT THE SECURITY PLAN.
 - 5 REMOVE AND DISPOSE OF FOUR EXISTING STEEL PLATES ON TOP OF MARINE WALL.
 - 6 REMOVE AND DISPOSE OF 31 LF OF EXISTING WOOD RAILING ACCORDING TO PROJECT SPECIFICATIONS.
 - 7 REMOVE EXISTING CONDUITS AND WATER PIPE ON EAST SIDE OF BERTH. DISPOSAL METHODS SHALL ADHERE TO PROJECT SPECIFICATIONS.
 - 8 REMOVE EXISTING VERTICAL SHADING STRUCTURE ON NORTH AND SOUTH SIDE OF CANOPY ACCORDING TO PROJECT SPECIFICATIONS.
 - 9 SAWCUT EXISTING CONCRETE AND ASPHALT AS REQUIRED FOR NEW CURB/RAMP CONSTRUCTION, ELECTRICAL CONDUIT INSTALLATION, LIGHT POLE INSTALLATION, AND CONCRETE PAD WITH TRANSFORMER TXD, PANEL D, AND NEMA CABINET (SEE SHEET E2). DO NOT SAWCUT EXISTING CONCRETE ON BERTH SURFACE. ⚠️
 - 10 ESA FENCE TO BE INSTALLED AND MAINTAINED PRIOR TO WORK.
 - 11 REMOVE EXISTING WOOD. REFER TO CONTRACT SPECIFICATIONS FOR DISPOSAL REQUIREMENTS.
 - 12 DEMO EXISTING WATER LINE TO THE EXTENTS SHOWN ON 1/U-1.

- GENERAL NOTES:**
1. MATERIAL REMOVAL OPERATION TO BE DONE BY CRANE AND/OR FORKLIFT. ALL NECESSARY MEANS SHALL BE TAKEN TO PREVENT DEBRIS AND HARDWARE FROM FALLING INTO THE WATER.
 2. EXCESSIVE CONCRETE ON BERTH AND/OR MARINE WALL SHALL BE GROUND DOWN TO A SMOOTH SURFACE AS NECESSARY FOR INSTALLATION OF NEW STEEL STRUCTURES.

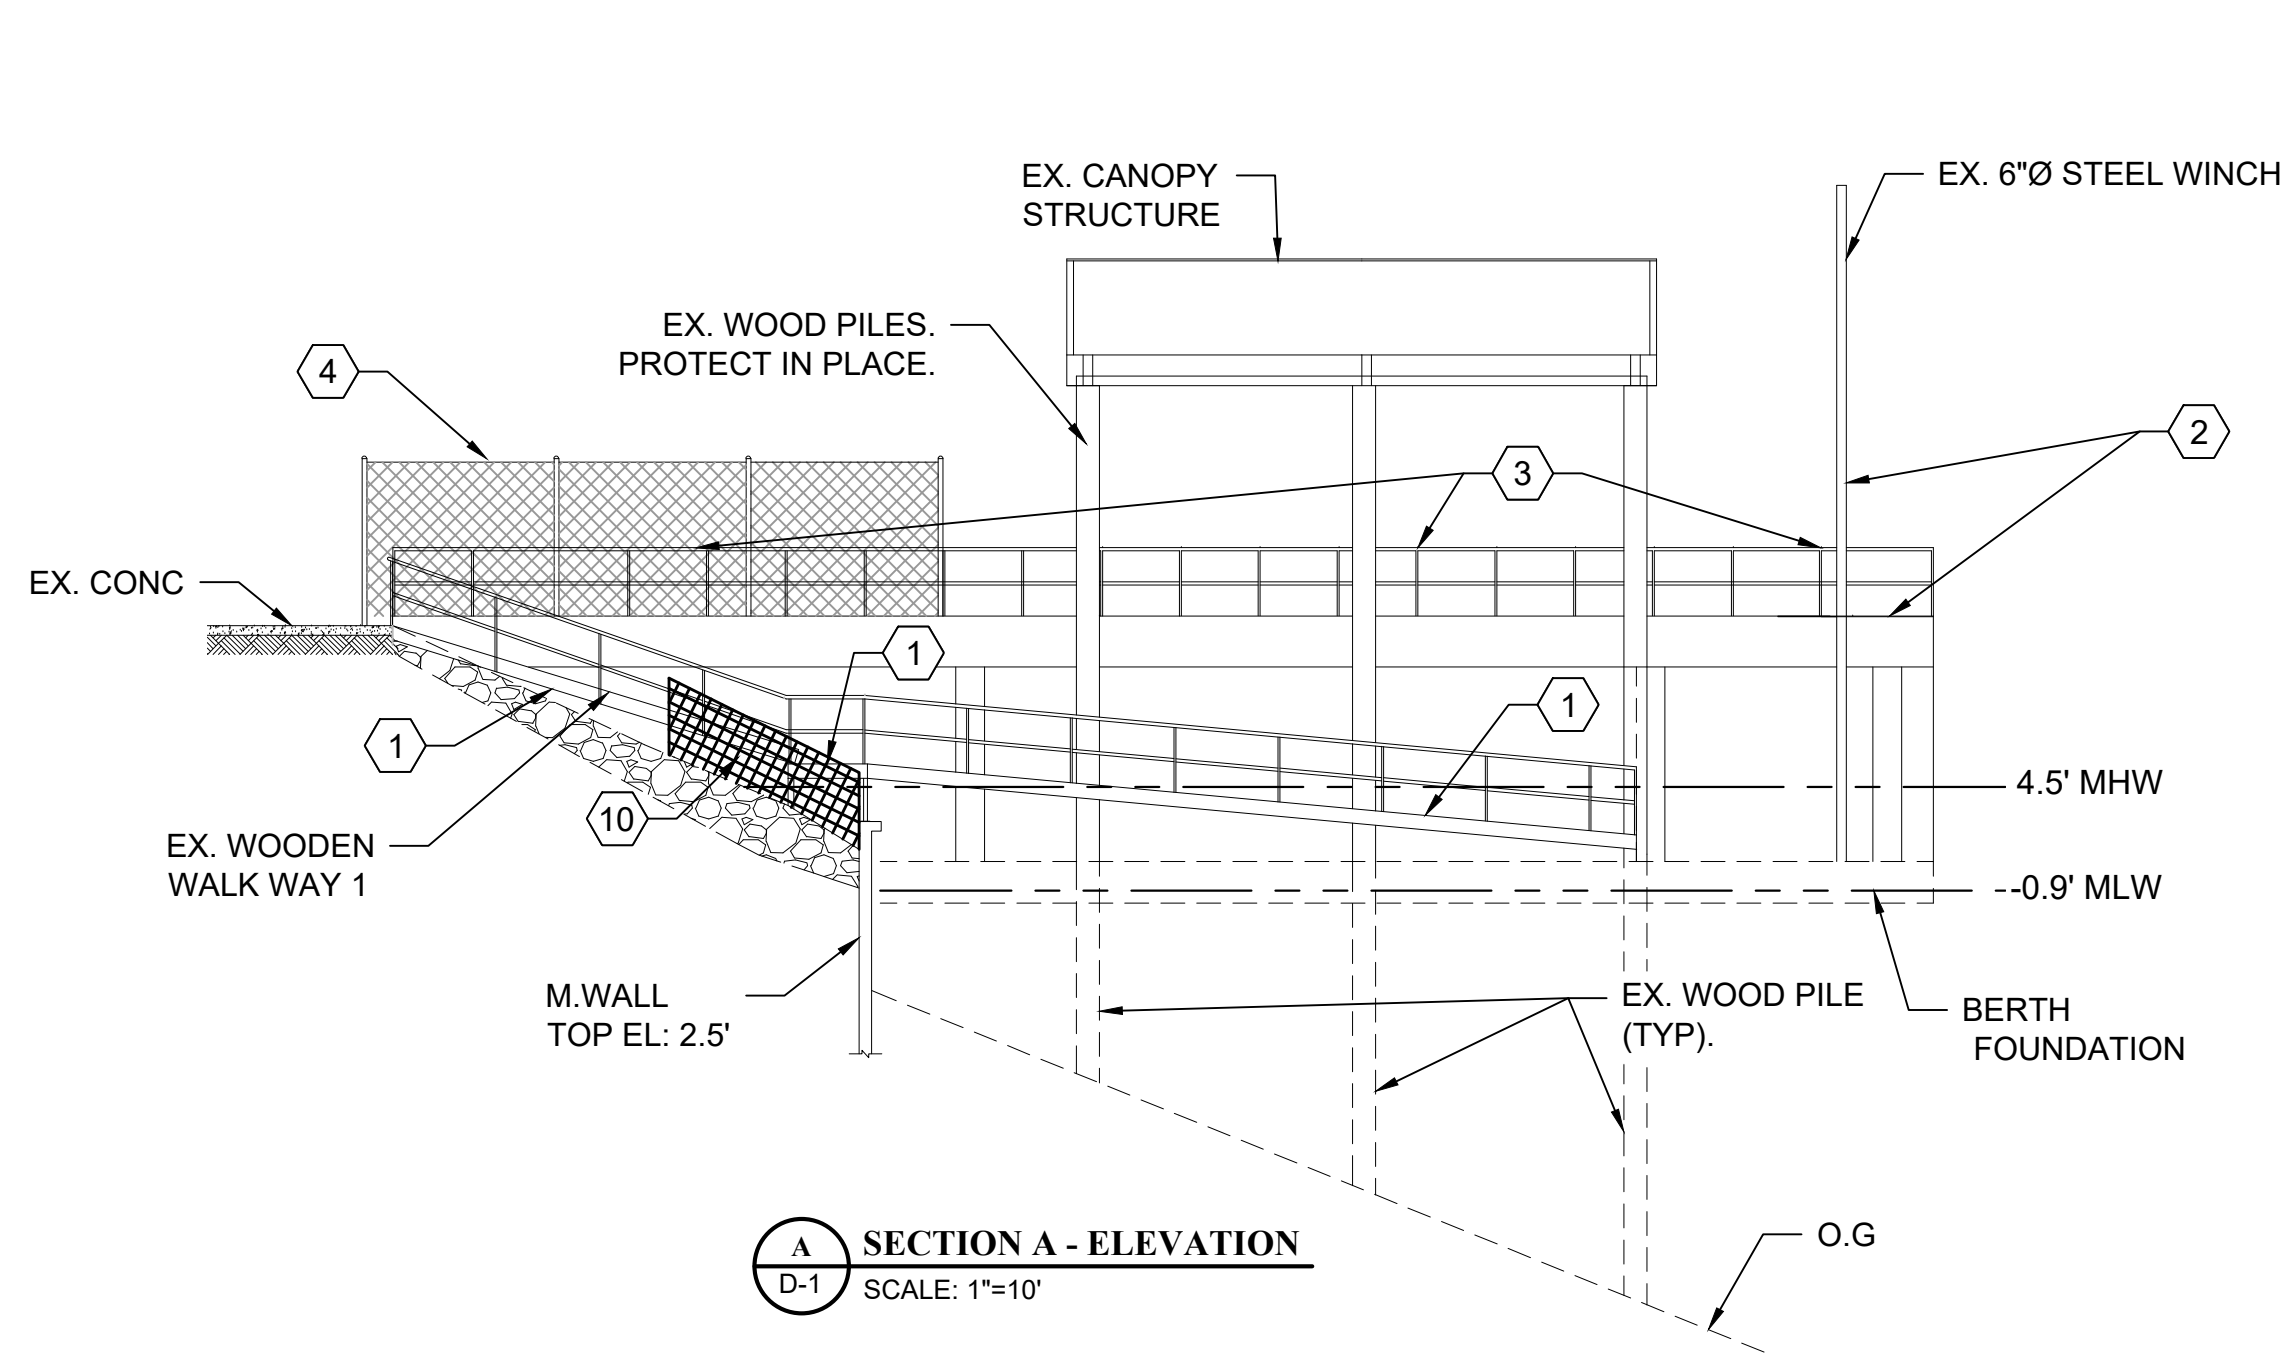

A
D-1
SECTION A - ELEVATION
SCALE: 1"=10'

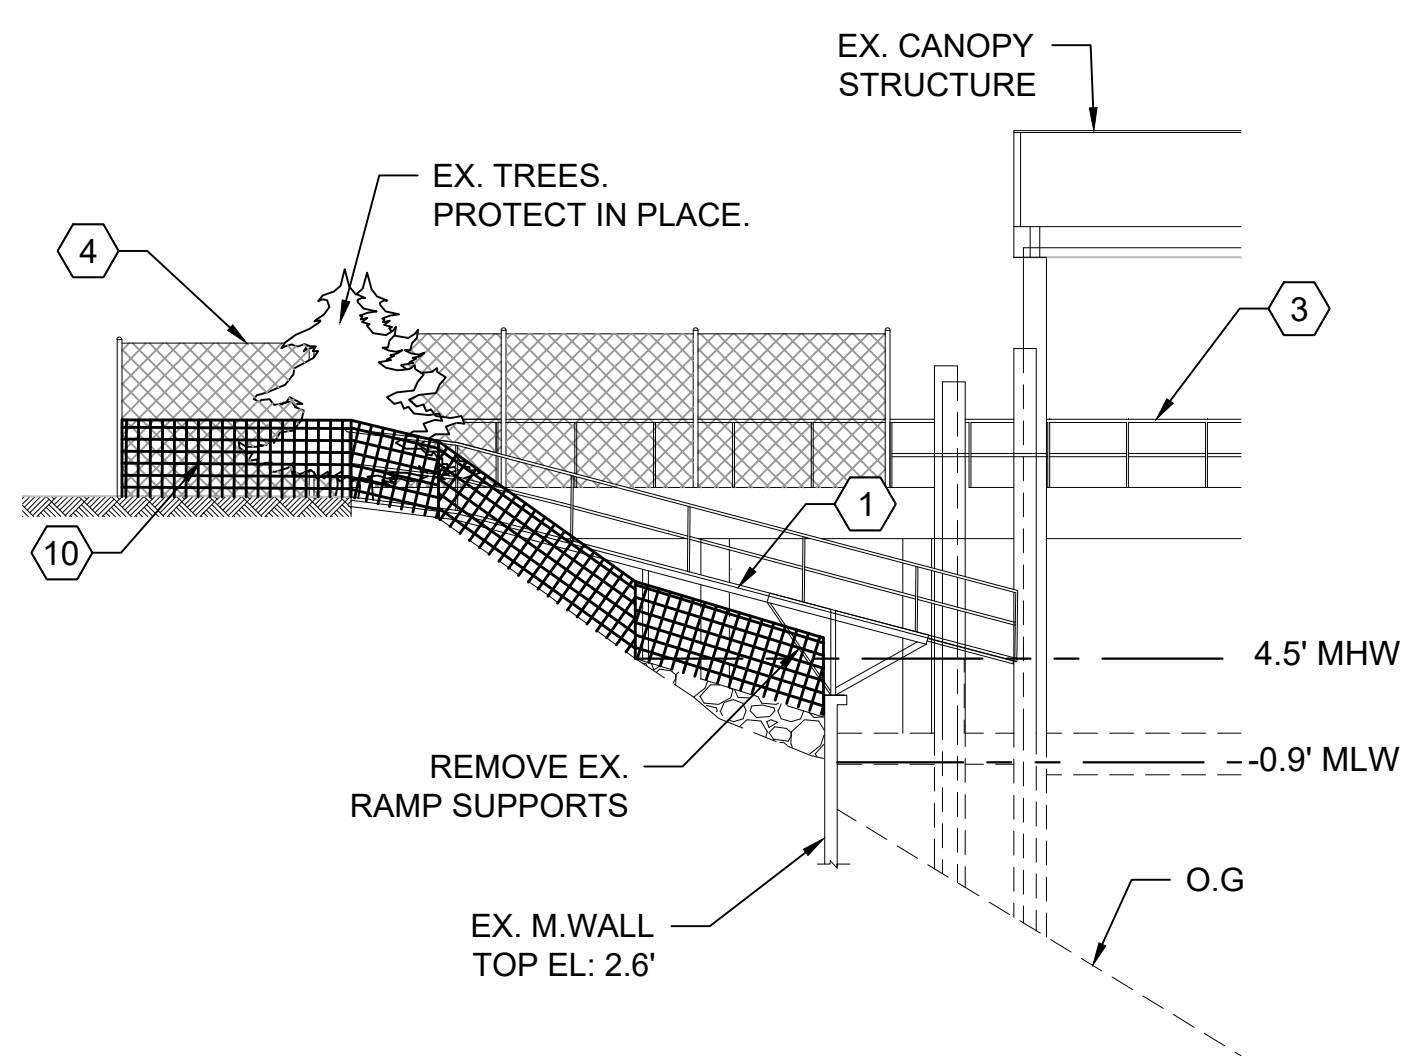

B
D-1
SECTION B - ELEVATION
SCALE: 1"=10'



DILLON & MURPHY ENGINEERING
847 N. CLUFF AVENUE
SUITE A-2, LODI, CA 95240
(209) 334-6613

PORT OF STOCKTON
RAPID RESPONSE BOAT PROJECT
DEMOLITION AND REMOVAL PLAN

STOCKTON, CALIFORNIA
MARCH, 2022

REV. NO.	DESCRIPTION	DATE	SCALE: AS NOTED	SHEET
2	ADDENDUM NO. 2	5/12/2022	DRAWN BY: FA, CH DESIGNED BY: S.Y. KIM CHECKED BY: S.Y. KIM AS BUILT BY:	D-1 4 OF 21 JOB NO. 1952
SEE SHEET 1 FOR BENCHMARK INFORMATION				

S:\2019\1952\CONSTRUCTION\MANAGEMENT\DM\1952\11\Information\Formed at Start of Project\Information\Address\No. 21\Sheet 21 - DEMOLITION May 12, 2022